

LEGEND :

RWP — RAIN WATER PIPE  
WP — WASTE PIPE  
CWS — COLD WATER SUPPLY PIPE

NEW DISCHARGE LINE  
NEW SUCTION LINE


RAIN WATER PIPE  
WASTE PIPE  
COLD WATER SUPPLY PIPE

GENERAL NOTES :

1. ALL DIMENSIONS ARE IN MM.  
2. ALL LEVELS ARE IN METERS.  
3. ARCHITECTURAL DRAWINGS TO BE RED IN CONJUNCTION WITH MEP- AND STRUCTURAL DRAWINGS.  
4. TANK SURFACE IS ALL AROUND RC WITHOUT COATING.  
5. NEW DISCHARGE & SUCTION LINE TO BE UPVC PN16 MATERIAL  
6. SPRAY NOZZELS TYPICAL INSTALLATION DETAIL REFER Dwg No-ADMM-MX-PU-500  
7. FOOT VALVE TYPICAL INSTALLATION DETAIL REFER Dwg No-ADMM-MX-PU-500  
8. ANCHOR FASTENER TYPICAL INSTALLATION DETAIL REFER Dwg No-ADMM-MX-PU-500  
9. NEWLY INSTALLED TREATED WITH GRP LINING.

ASBUILT DRAWING

AB 28.04.2016 UPDATED ASBUILT AS PER COMMENTS SG  
AB 24.04.2016 ASBUILT SG  
AB 14.03.2016 ASBUILT SG

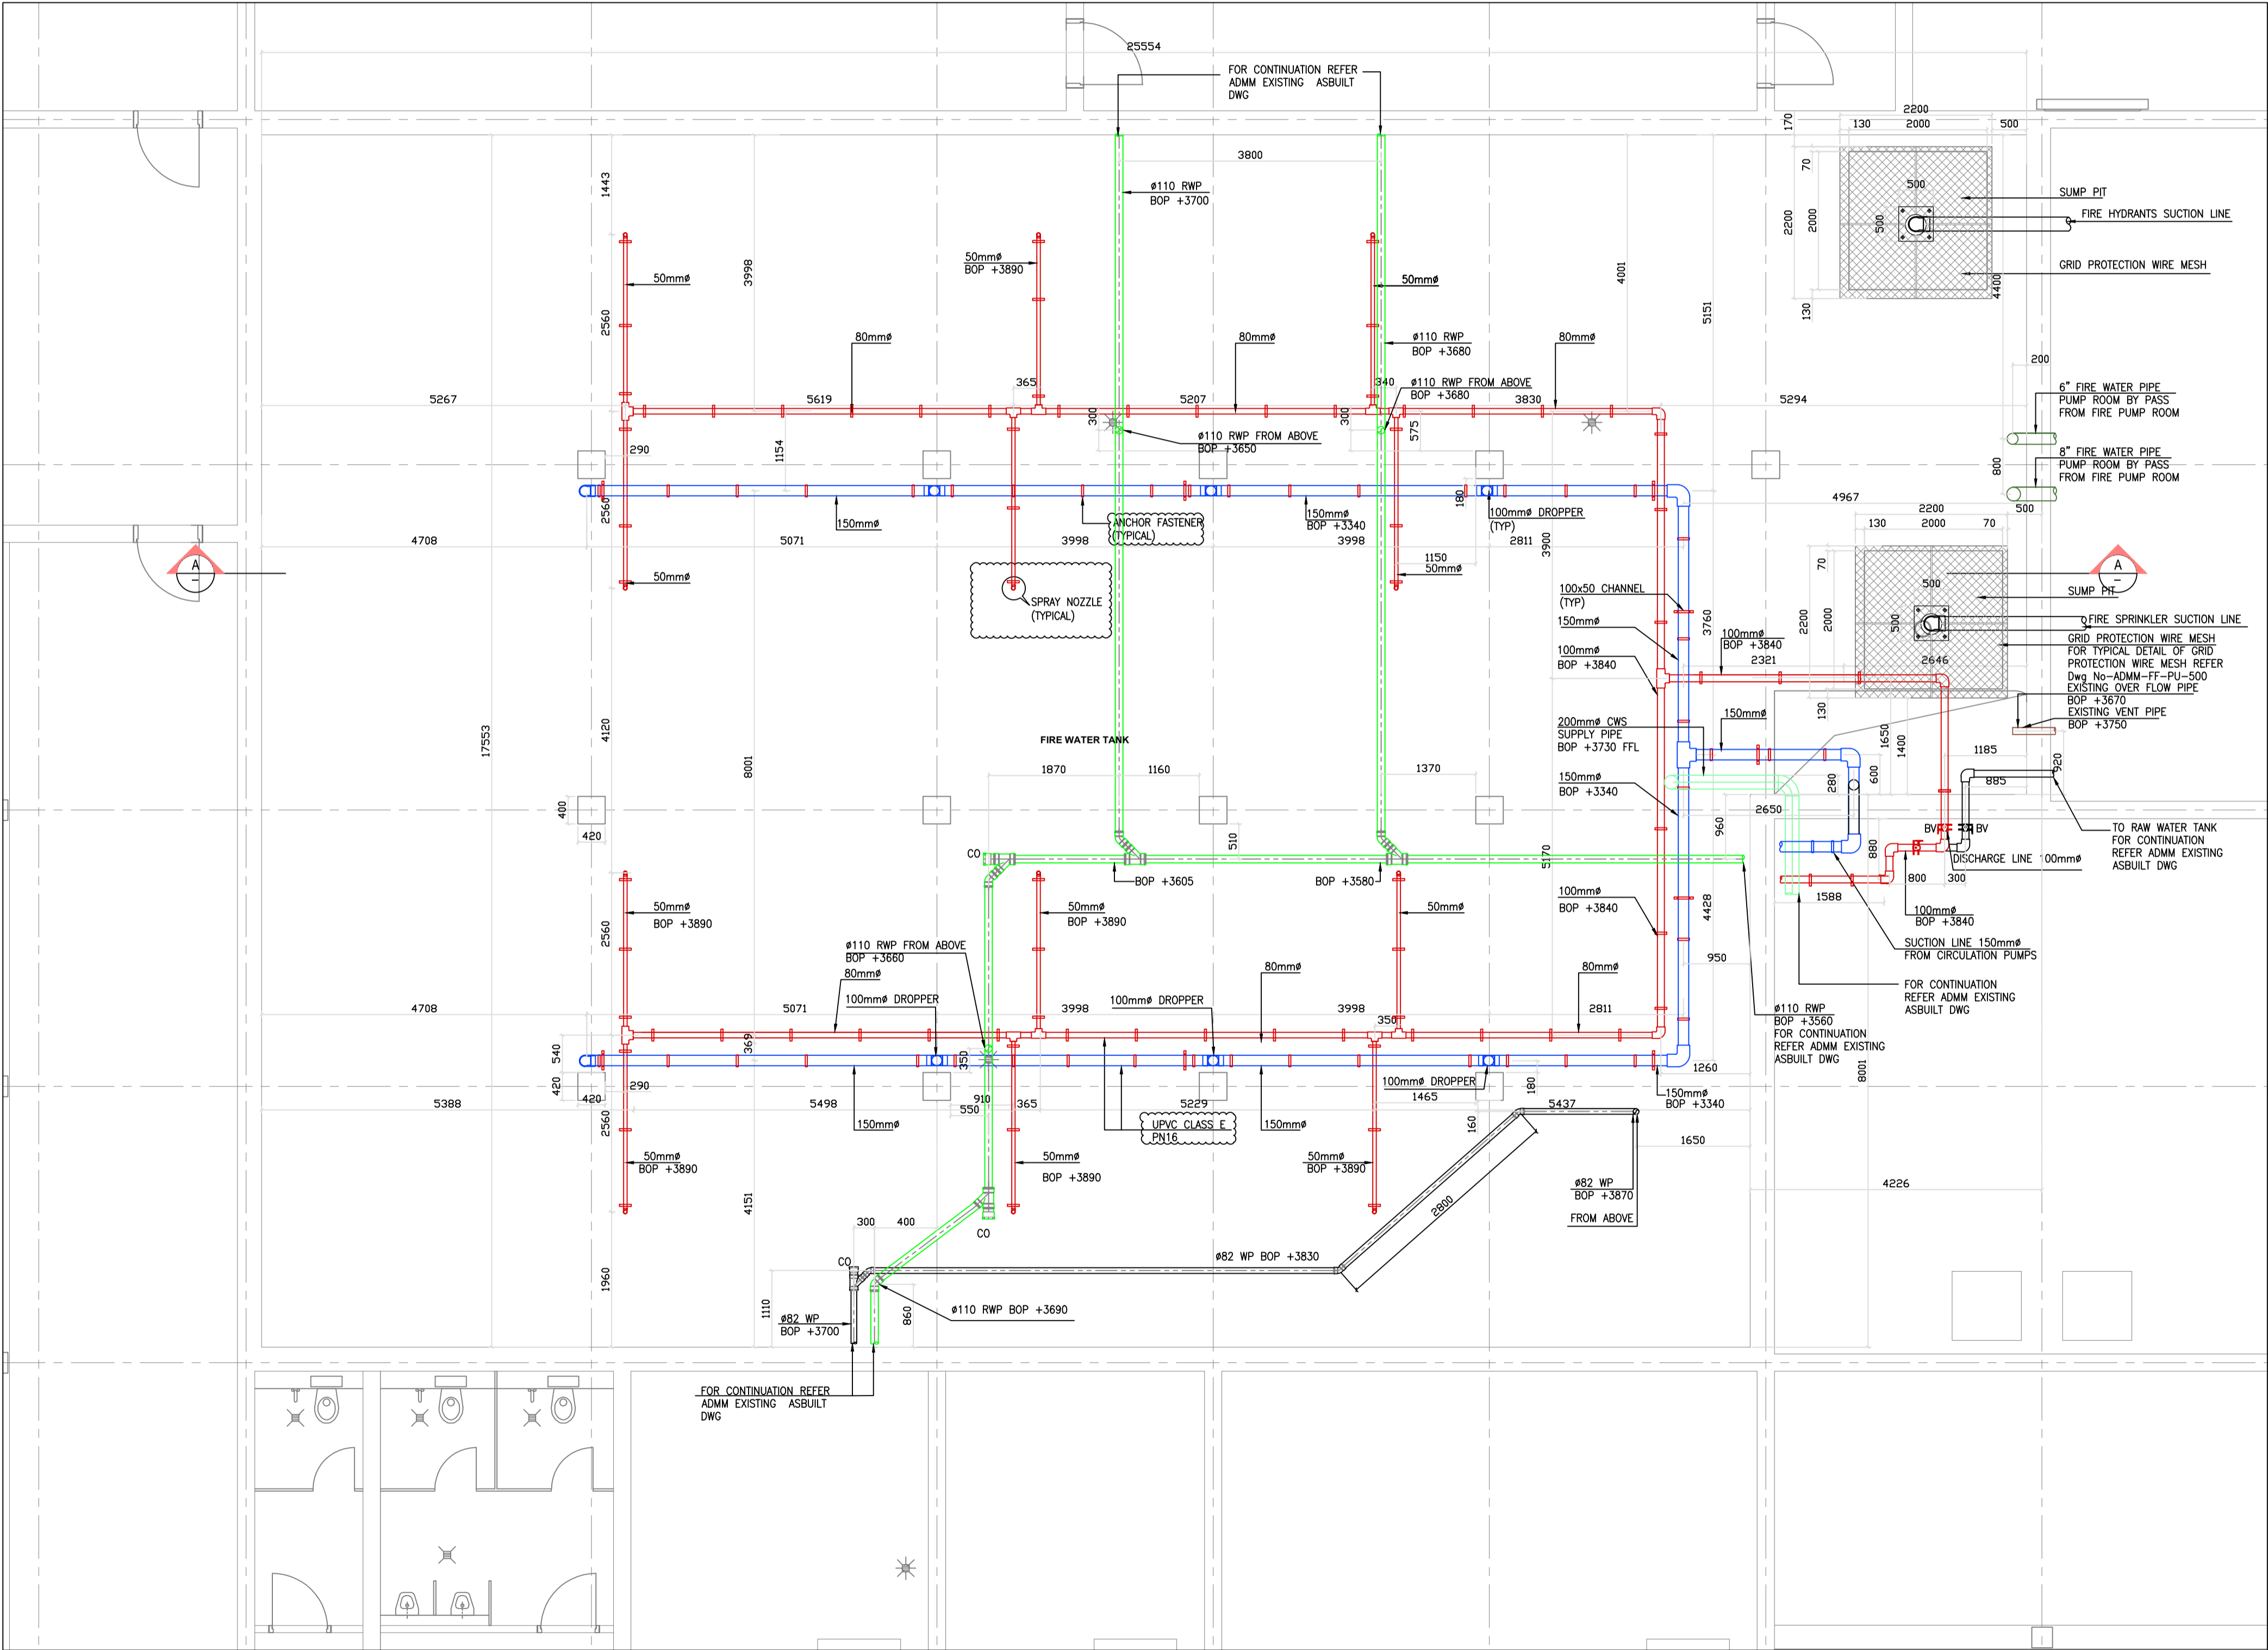

FIRE FIGHTING WATER  
RECIRCULATION PIPE LAYOUT

GP SG GF  
28.04.2016 28.04.2016 28.04.2016  
ADMM-FF-PU-100 AB