


Drainage Repair As Built

Arrows denote direction of slope downward and flow of water in drains

Key:
□ = 1 foot
□ = Type SD Catch Basin
X = French Drain See Detail A
= = 6" SDR35 Solid Pipe

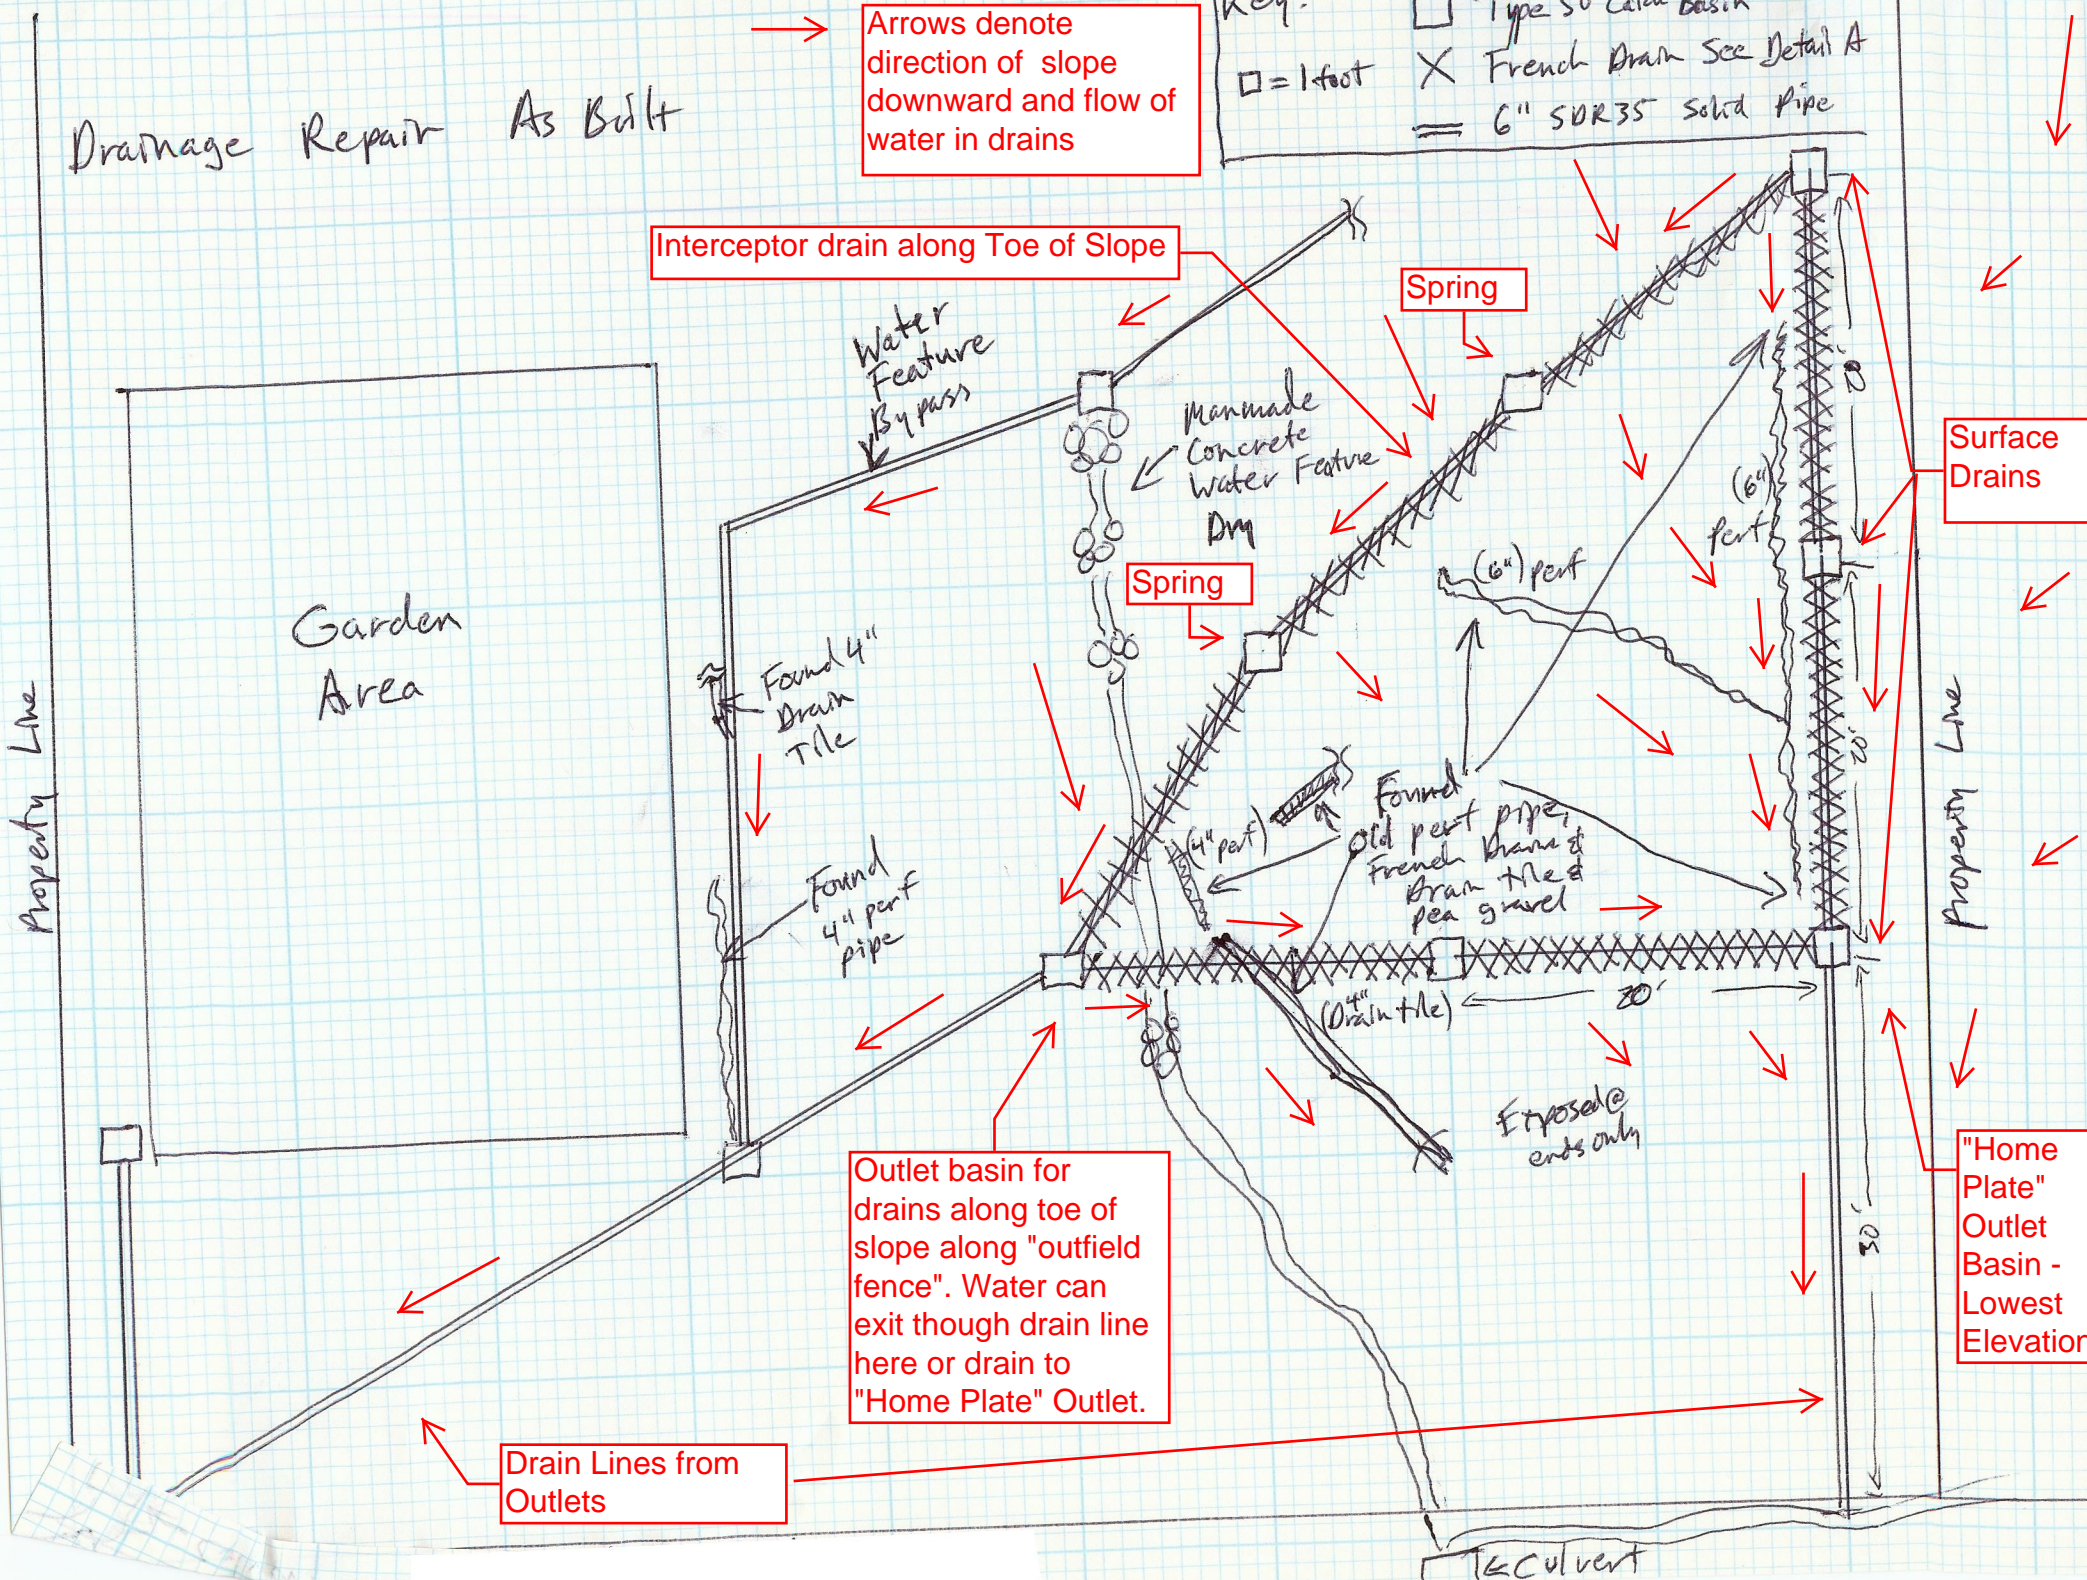

Interceptor drain along Toe of Slope

Spring

Surface Drains

Garden Area

Property Line

Property Line

Found 4" Drain Tile

Found 4" perf pipe

Found Old perf pipe, French drain of drain tile & pea gravel

Spring

(4" perf)

(6" perf)

(4" Drain tile)

20'

Exposed @ ends only

Outlet basin for drains along toe of slope along "outfield fence". Water can exit though drain line here or drain to "Home Plate" Outlet.

"Home Plate" Outlet Basin - Lowest Elevation

Drain Lines from Outlets

Culvert