


14:202

PIPELINE DESIGN DATA

NOMINAL DIAMETER	20"
WALL THICKNESS, mm	10.49(0F-0.6)/B.91(0F-0.72)
CORROSION ALLOWANCE	1 mm
ISO 3183-PS2 GRADE L415 (X60)	
DESIGN PRESSURE, MPa(g)	DEP 31.40, 20.37, SOUR SERVICE
PIPELINE MATERIAL GRADE	
DESIGN TEMPERATURE, °C MAX	82
DESIGN TEMPERATURE, °C MIN	-10
DESIGN CODE	ASME B31.8
ASME CLASS	600#
MIN. I.D. OF THE SYSTEM	487.02 mm
COATING EXTERNAL	3LPE
APPROX. LENGTH	157 km
MIN. HOT BEND RADIUS	30
MIN. COLD BEND RADIUS	400
DESIGN GAS FLOW RATE	2.144MMSCM3/d
CATHODIC PROTECTION (IMPRESSIONED CURRENT)	YES

A-1451 NOTE 1  
SCRAPER LAUNCHER  
DIA MAJOR/MINOR : 24"x20"  
DESIGN. TEMP. : -10/-82  
DESIGN. PRESS. : 9270 kPa(g)  
BARREL LENGTH (MAJOR/MINOR) : 5100/1500 mm  
WALL THICKNESS (MAJOR/MINOR) : 12.7mm/10.49 mm  
CORROSION ALLOWANCE : 1 mm

A-1410  
ORAIN PIT  
L x B x D : 1.25m x 1.5m x 1.5m

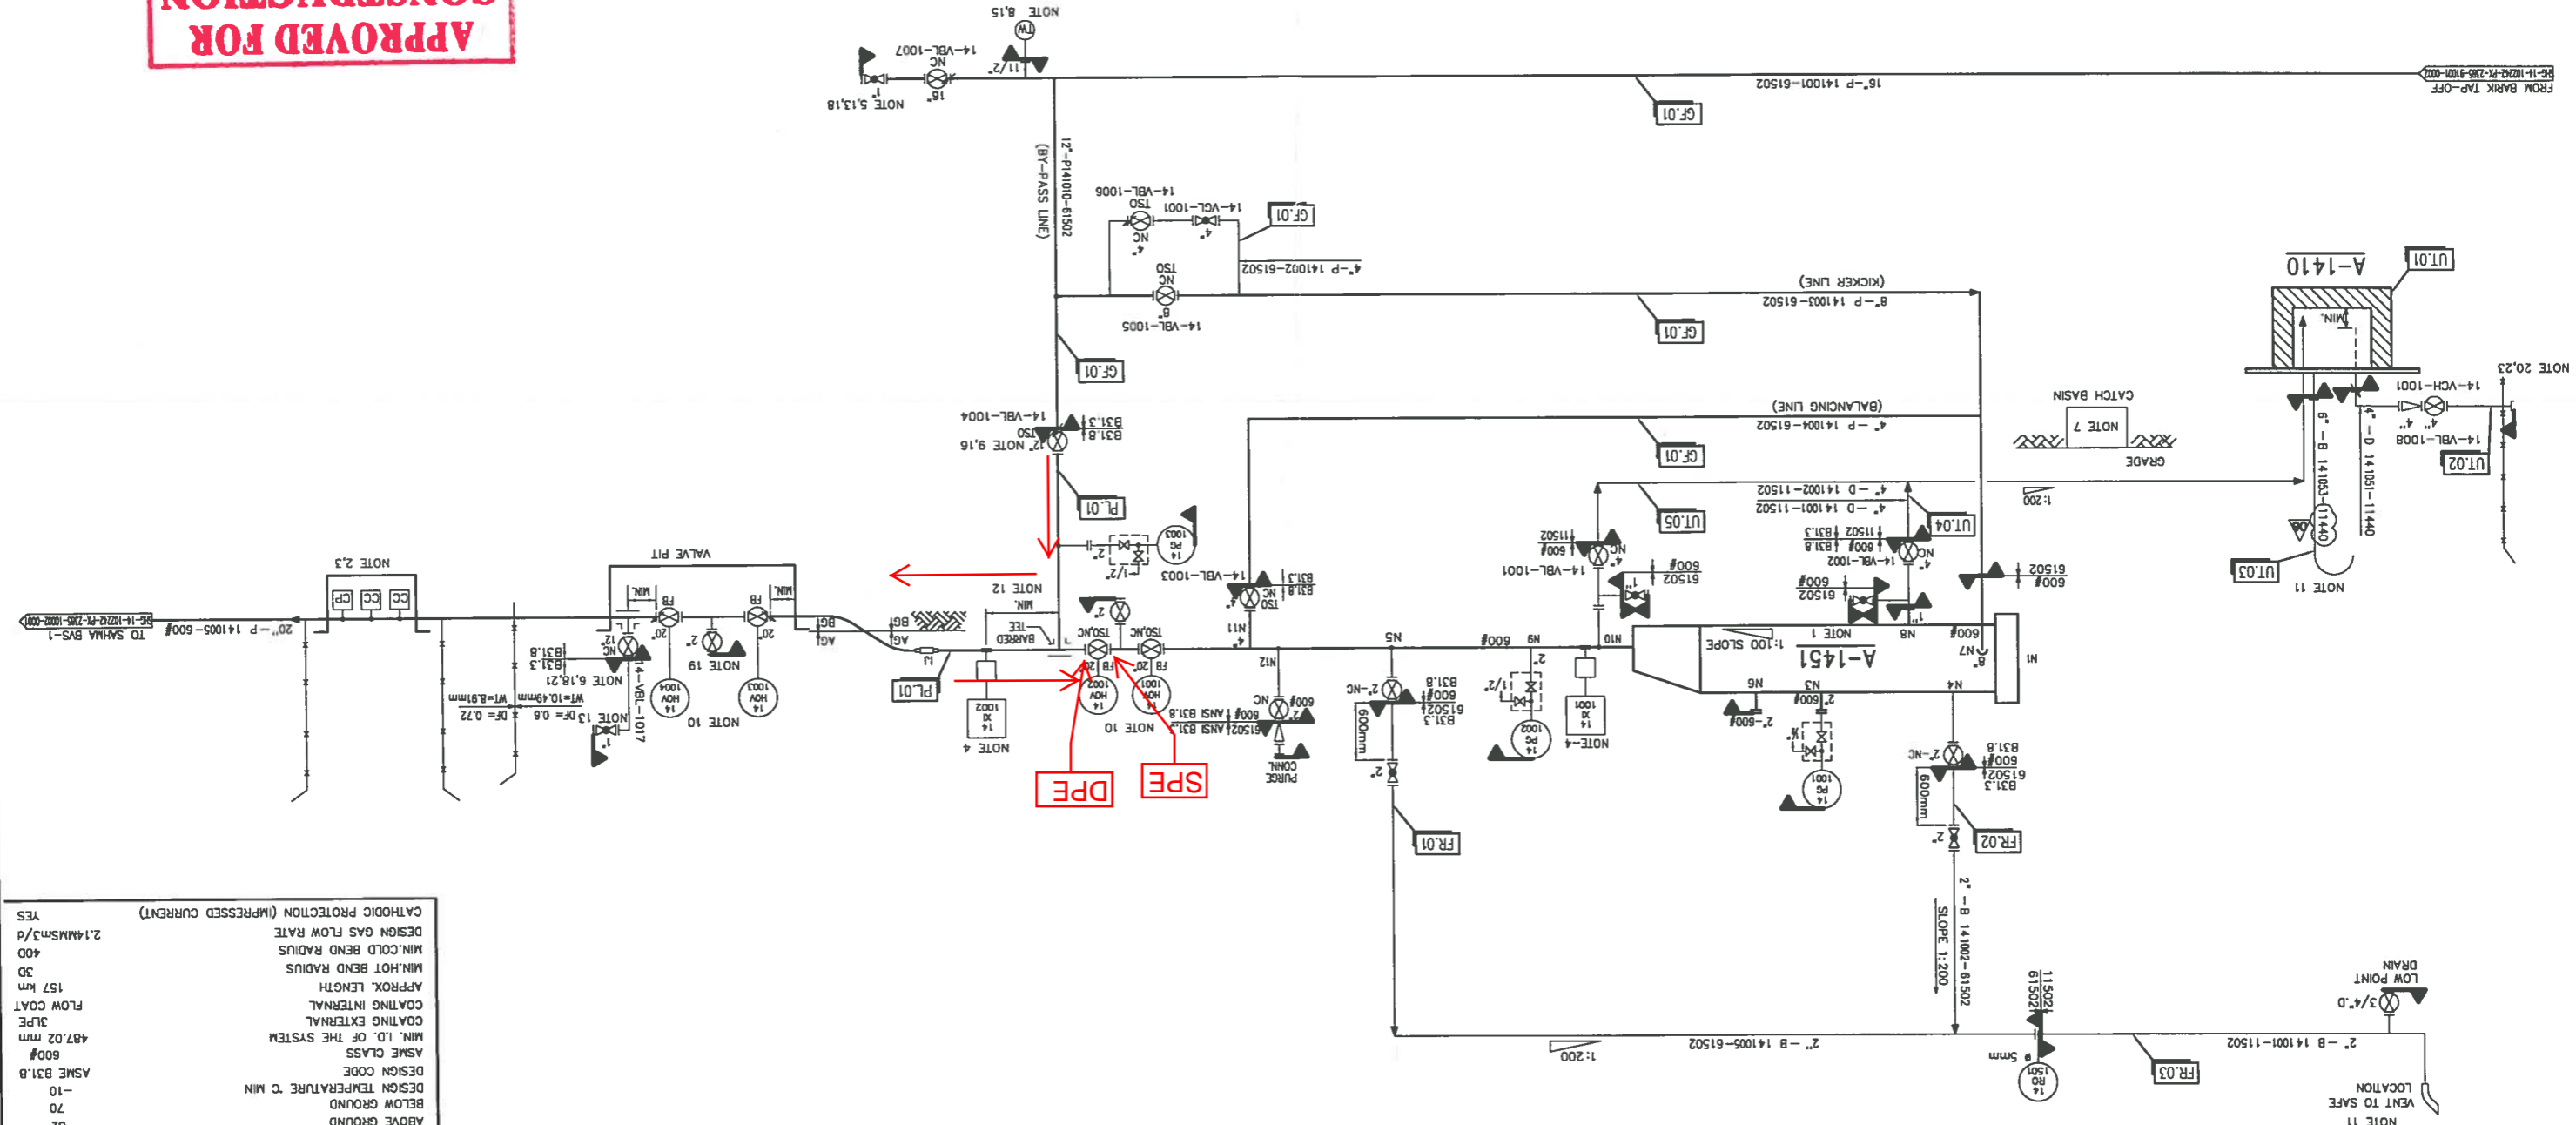

**APPROVED FOR CONSTRUCTION**  
Date 16-DEC-2018  
Signed [Signature]

THIS ENTIRE DRAWING IS NEW AND  
BASED ON FEED DRAWING NO.:  
SHG-14-104321-PX-2365-10001-0001-04

CMMS SUB SYSTEM NUMBER  
14-1-IF.12.003.1203-XX.YY  
XX-SYSTEM PROCESS CODE  
YY-SUB SYSTEM NUMBER

- NOTES
1. SCRAPER TRAP DESIGN & LAYOUT IN ACCORDANCE WITH DEP 31.40.10.13-GEN
  2. CORROSION MONITORING FITTINGS SHALL BE INSTALLED AT LOWER POINTS AS PER STANDARD DRAWING NO. STD-2-4016-001-01.
  3. ENSURE 1.5m CLEARANCE BELOW PIPE INSIDE THE PIT.
  4. NON-INTRUSIVE TYPE PIG SIGNALER.
  5. PROVISION FOR VENTING DURING COMMISSIONING AND FUTURE PIPELINE EXTENSION TO KP 24.5.
  6. FUTURE PROVISION FOR EXTENDING PIPELINE TO KP 24.5.
  7. CATCH BASIN IS PROVIDED NEAR PIG TRAP DOOR WITH GRATING COVER AT THE TOP.
  8. WALL TEMPERATURE REMAINS ABOVE -10°C.
  9. VALVE SHALL BE OF PIPELINE SPECIFICATION WITH PORT FOR VENT/DRAIN/SEALANT INJECTION.
  10. ALL THE 20" MAIN LINE VALVES SHALL HAVE HYDRAULIC ACTUATION BY MOBILE POWER UNIT. EXISTING MOBILE POWER UNIT TO BE USED.
  11. VENT LINE TO BE MIN 3M HEIGHT FROM GROUND LEVEL.
  12. MINIMUM LENGTH EQUAL TO THE MAXIMUM LENGTH OF THE INTELLIGENT PIG. LENGTH OF 5.1 MTS FOR 20" LINE.
  13. TELL TALE VALVE.
  14. THE INSTRUMENT TAG NOS. EQUIPMENT TAG NOS. LINE NO AND DRAWING NOS ARE FROM 292003 QAD7 PROJECT.
  15. PROVISION OF TEMPERATURE GAUGE.
  16. VALVE SHALL BE MANUAL GEAR OPERATED.
  17. DELETED.
  18. DELETED.
  19. THE 2" CONNECTION SHALL IN 12 O'CLOCK POSITION SHALL BE ABOVE GRADE.
  20. EARTHING CONNECTION PROVIDED FOR VACUUM TRUCK.
  21. VALVE SHALL BE LOCATED ABOVE GROUND.
  22. SYSTEM SHALL BE PRESSURISED PRIOR TO DRAINING.
  23. VACUUM TRUCK CONNECTION : 4" MALE ELFLUX COUPLING WITH END CAP.

REV	DATE	BY	APP'D	DESCRIPTION
REFERENCE DRAWINGS										MASTER DRAWING REVISION										IN CASE OF DEVIATIONS A MARKED UP PRINT SHALL BE SENT TO COASTAL DESIGN OFFICE	
DESCRIPTION					DRAWING NUMBER					REV					DATE (QUALITY BY)					APPROVED BY					DESCRIPTION					REV					DATE (QUALITY BY)					APPROVED BY					DESCRIPTION	
