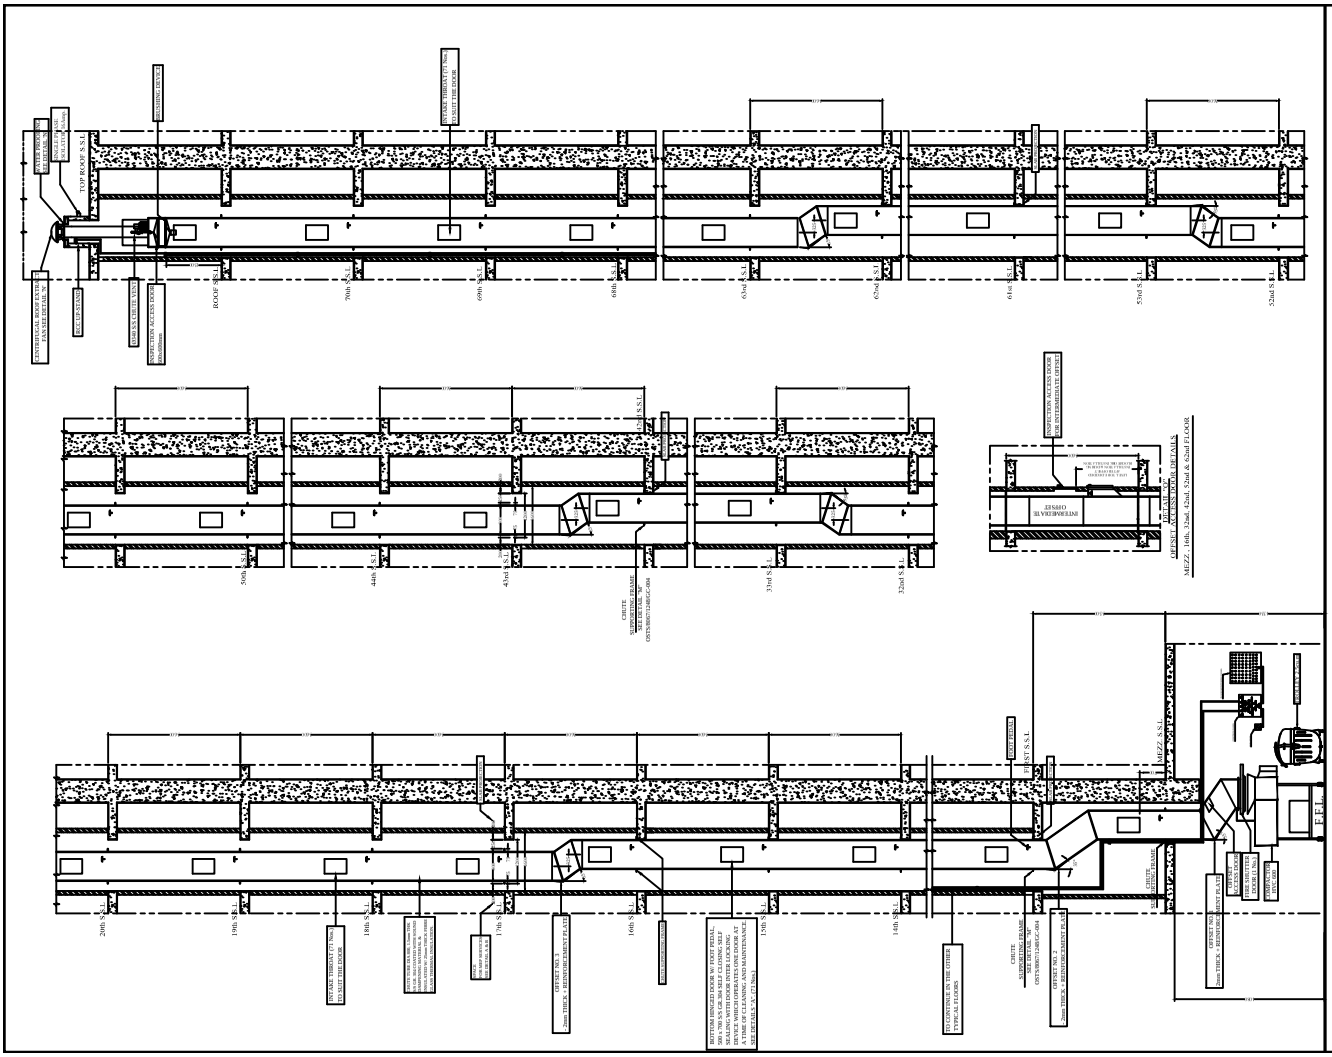

NOTES:

1. ALL DIMENSIONS ARE IN mm.

AS-BUILT

H.H.H.H TOWER

COMM./ RESIDENTIAL TOWER

DUBAI INT'L REAL ESTATE

AL HASHEMI

Ian Bonham & Associates
CONSULTING ENGINEERS

BLAFS-ADDITION

M/s. AL AHMADIAH - HIP HING JV
DUBAI, U.A.E.

M/s. OSTERMEIER FZE
P.O.Box - 61378,
JEBEL ALI, DUBAI, U.A.E.

Drawing Title:
GARBAGE CHUTE SYSTEM
MEP PLAN & SECTION LAYOUT

Height:	Scale:	Comments:
G+M+70	1:50, 1:10	TRADE CENTER FIRST

Drawn by:	Approved:	Date:
M.K.	A.J.	27.05.2010