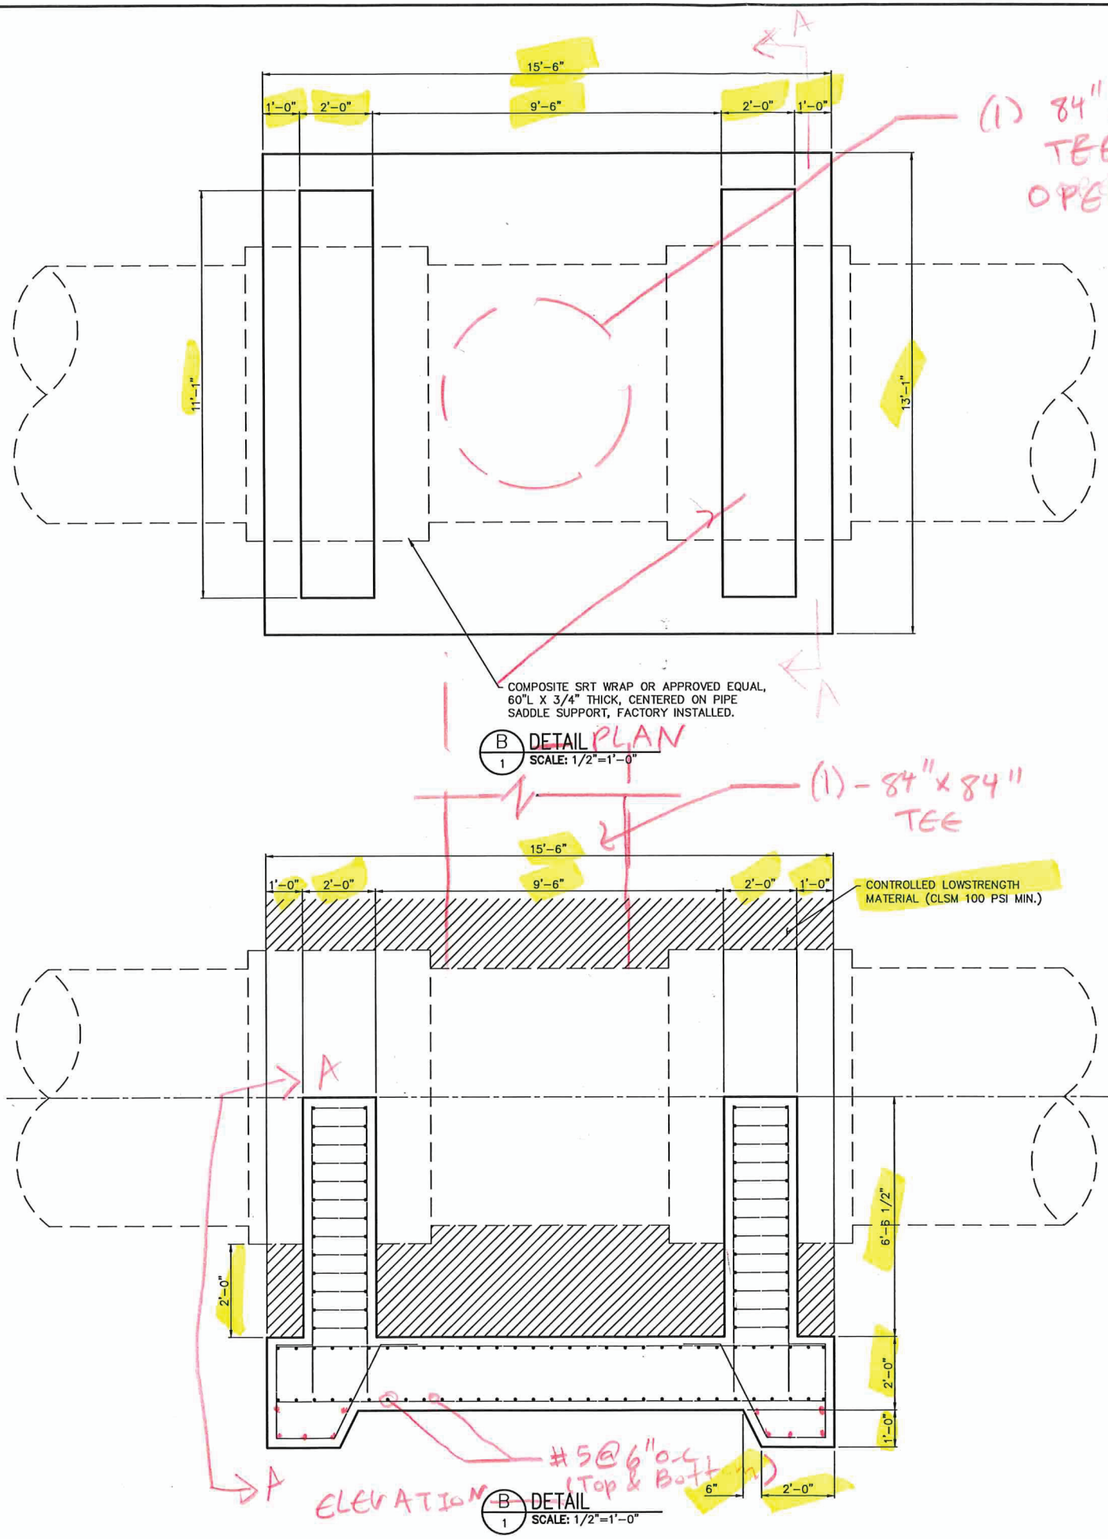

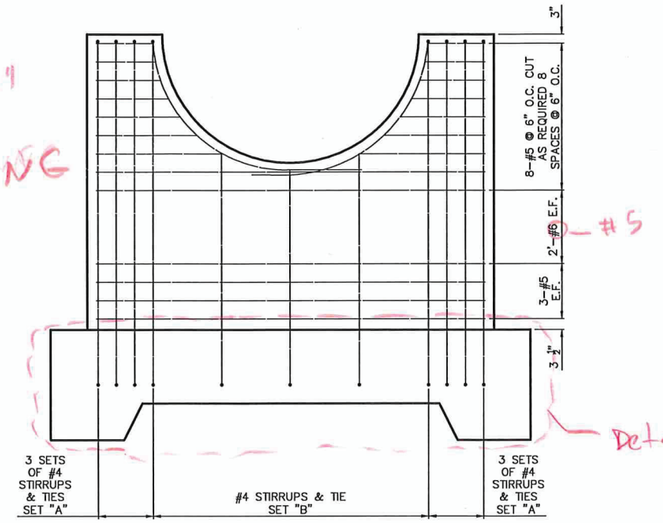

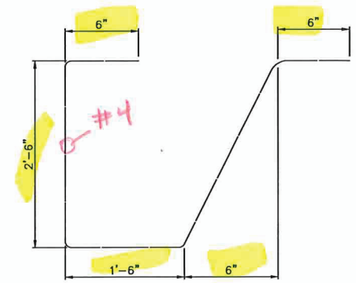

B 1 DETAIL
SCALE: 1/2"=1'-0"
REBAR-1 Detail

No.	Date	Revisions	App.

B 1 DETAIL
SCALE: 1/2"=1'-0"
PEDESTAL REINFORCEMENT

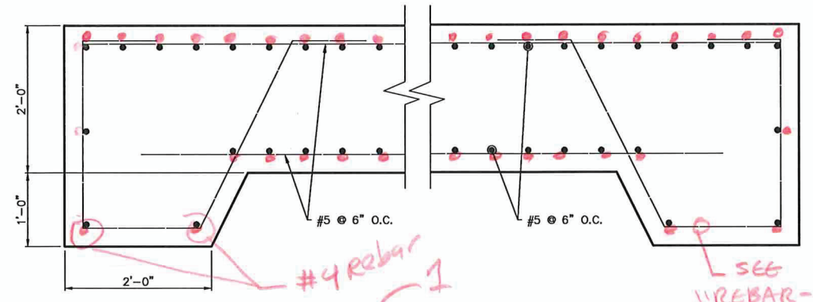

B 1 DETAIL
SCALE: 1/2"=1'-0"

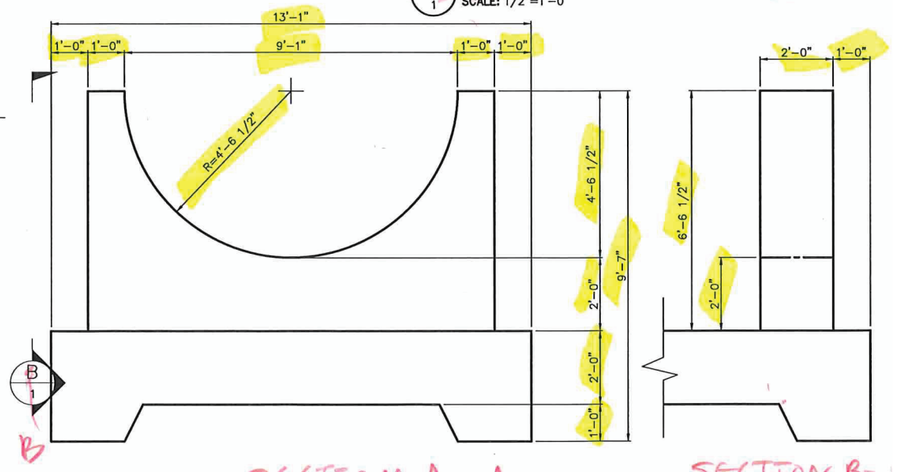

A 1 DETAIL
SCALE: 1/2"=1'-0"