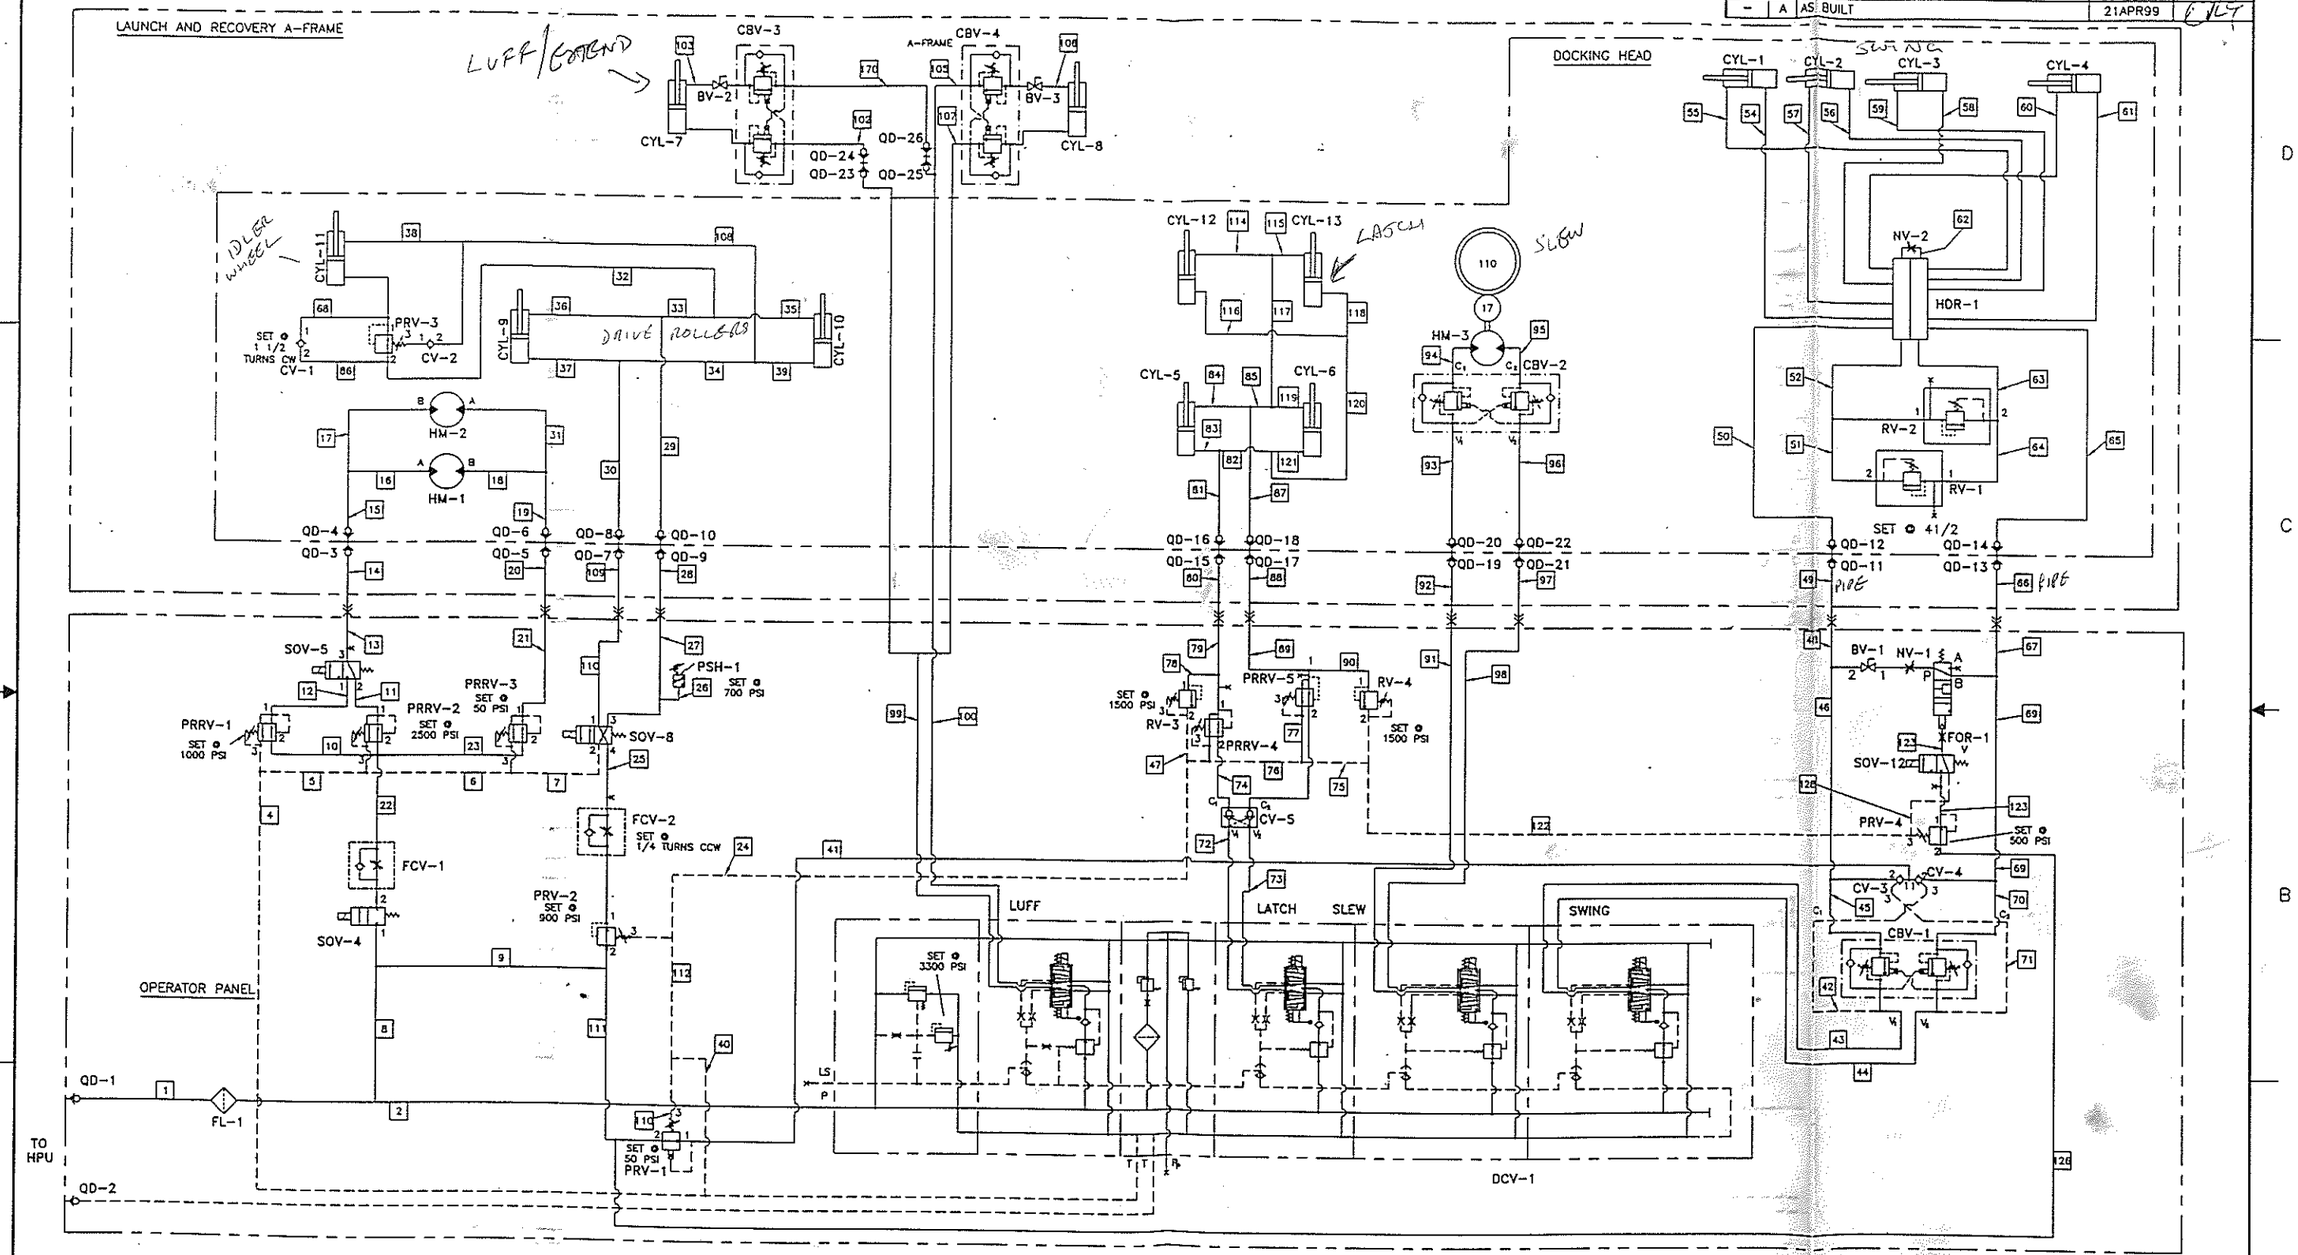

REVISION HISTORY				
ZONE	REV	DESCRIPTION	DATE	APPROVED
–	A	AS BUILT	21APR99	

UNLESS OTHERWISE SPECIFIED: DIMENSIONS ARE IN INCHES. TOLERANCES ARE:
FRACTIONS ± 1/16 DECIMALS .XX ± .02 .XXX ± .005 ANGLES ± 1/2
REMOVE BURRS, BREAK SHARP EDGES.
MATERIAL: 557-8009-01 COMPONENTS; 557-8009-02 FLOW LINES
FINISH 125 APPROX. WEIGHT, LBS
DO NOT SCALE DRAWING

CUSTOMER P.O. No.	DYNACON JOB No. 557	
APPROVALS		DATE
DRAWN	SJS	13JAN99
DRAFTING CHECK	AL	29JAN99
ENGINEERING CHECK	DRT	29JAN99
ENGINEERING APPROVAL	TS	2FEB99
PRODUCTION APPROVAL	DJ	2FEB99

THIS DRAWING IS THE PROPERTY OF DYNACON, INC. 831 INDUSTRIAL BLVD. BRYAN, TEXAS USA 77803

ANY REPRODUCTION OR USE OF THIS DESIGN IS EXPRESSLY FORBIDDEN UNLESS AUTHORIZED IN WRITING.

LAUNCH AND RECOVERY SYSTEM HYDRAULIC SCHEMATIC

SIZE	CAGE CODE	DWG NO.	REV
D	OFSDO	557-8001-01	A
SCALE	NONE	PATH J:\557\HYD\55780101	SHEET 1 OF 1

21APR99 15:29